

UNITED STATES PUBLIC LAND SURVEY CORNER CERTIFICATE

OF

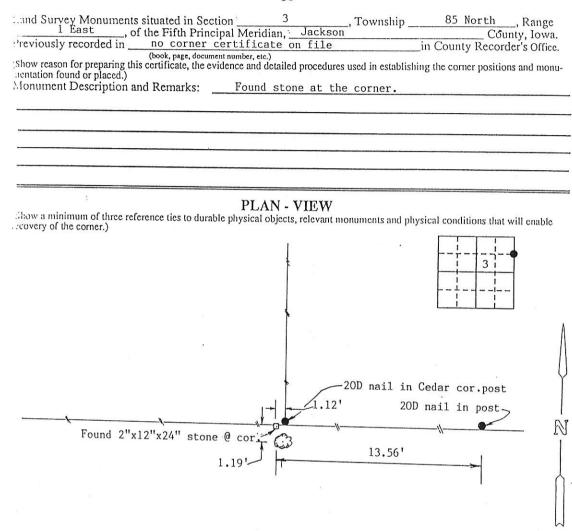

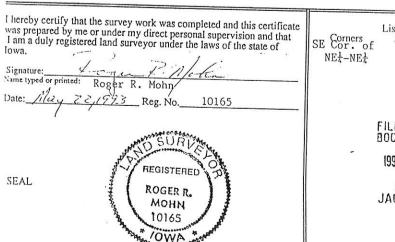


List Corners to be Indexed
SE Corners
Section Twp Range
NE¼-NE¼ 3 85N 1E

FILE NO 003306 BOOK ___ PAGE ___ 37

1993 HAY 25 AH 10: 06

SHIRLY RITEHOUR JACKSON COUNTY, IOWA RECORDER /

Land Survey Monuments 1 East . of	situated in Section the Fifth Principal Meridian	, lowi	nship <u>os North</u> , County	
Previously recorded in	no corner certif:	icate on file	in County Recorder'	's Office.
Show reason for preparing thi	(book, page, document number, etc.) s certificate, the evidence and deta	ailed procedures used in	establishing the corner positions a	and monu-
mentation found or placed.)			_	
Monument Description at	id Remarks: Establis	shed corner locat	tion using county road i	notes_
and measuremen	ts to other corners in	Section 3. Set	iron rod.	
				
. *	PI.AN	- VIEW		
Show a minimum of three ref	erence ties to durable physical obj	ects, relevant monumen	ts and physical conditions that will	l enable
ecovery of the corner.)	8.			
			L_i_I_i_1	
	County Highway		3	
		^		
			_	
		-		
	*	= 0	3	
	e	58.83'		
for	ce ¬			,
Len	ce ,	"x" nails	in cor. post	
0 1117		, and its	in cor. posc	
	iron rod at the			£
corner.	2.00'	The state of the s		2.
		27.35'		
		'"x"	nails in power pole	
				(
				1
	. D.V			1
	$\Delta = P.K.$ nai	I in HWY. G		,
40				
				
hereby certify that the survey	work was completed and this cer	tificate	List Corners to be Indexed	

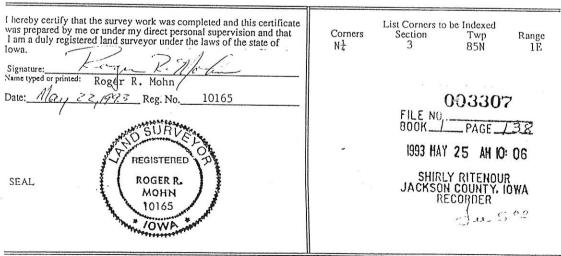

UNITED STATES PUBLIC LAND SURVEY CORNER CERTIFICATE

OF

	, Township <u>85 North</u> , Range Jackson County, Iowa.
Previously recorded in no corner certificate on (book, page, document number, etc.)	
(Show reason for preparing this certificate, the evidence and detailed proc mentation found or placed.) Monument Description and Remarks: Established cor	
SE corner to the NE corner of the SE ¹ / ₄ -NE ¹ / ₄ of	
· ·	the beetion, bet 3 b from 100.
PLAN - VIE	ZW .
(Show a minimum of three reference ties to durable physical objects, rele recovery of the corner.)	vant monuments and physical conditions that will enable
	3
	λ
Cult. Land	
Curt. Land	
	\ \
Set	½" ø iron rod at corner
	£ Control of the cont
	75.00'
56.75'—	
75 001	Set $\frac{1}{2}$ " ϕ rod for ref.
75.00	Set 2 p lod for rer.
	· · · · · · · · · · · · · · · · · · ·
	20D nail in wood post
é	Set $\frac{1}{2}$ " rod for reference
	fence
I hereby certify that the survey work was completed and this certificate was prepared by me or under my direct personal supervision and that	List Corners to be Indexed
and a duly registered land surveyor under the laws of the state of	Corners Section Twp Range
Iowa.	$E_4^{\frac{1}{4}}$ 3 85N 1E
Signature: A forting Name typed or printed: Roger R. Mohn	
noggi k. Homi	20208
Date: ///62 Reg. No. 10165	FILE NO NOT / 3 9
SURICE	BOOK PAGE LS 4
	1993 HAY 25 AM 10: 06
REGISTERED	1000 1
SEAL ROGER R.	SHIRLY RITEHOUR JACKSON COUNTY, IOWA
MOHN 10165	
* / () 14 () ** ** ** ** ** ** ** ** ** ** ** ** **	Les Sie
Manage And Andreas	*