PREPARED BY: HINKLE SURVEYING 1117 SPRINGBROOK LANE OCIMIT, IA 52742 PHONE (553) 219-1087

MANUAL MA

Book 2018 Page 1250 Type 15 001 Pages 1 Date 4/23/2018 Time 3:15 PM Rec Amt \$7.00

ARLENE SCHAUF, RECORDER/REGISTRAR JACKSON COUNTY 10MA

UNITED STATES PUBLIC LAND SURVEY CORNER CERTIFICATE

(JF.			
Land Survey Monuments situated in Section 6 F , of the Fifth Principal A	8	, Township	84 N	. Range
Previously recorded in N/A	Aeridian,	JACKSON County Record	Count	ty, lowa.
(book, page (Show reason for preparing this certificate, the evidence a positions and monumentation found or pinced.)	e, document numb and detailed proce	er, etc.) dures used in es	tabilahing the carr	
Monument Description and Remarks: SET 5/8" REBAR	WITH BLUE CAI	P NO. 18875 A	THE NORTHEAS	T CORNER
NORTHWEST QUARTER OF THE NORTHEAST QUARTER O	N LINE BETWEEN	THE N 1/4 C	OR, AND N.E. CO	R. AND
AT A DISTANCE THAT IS IN LINE WITH THE OLD FENCE				
PREPARED CERTIFICATE BECAUSE NONE FOUND ON FIL	E AT THE RECO	RDER'S OFFICE.	· ···· ·	
JOB # 18-1986 DRURY FARM SURVEY 3	· -	·— <u>—</u> -·— <u>—</u>		
SET 5/8" REBAR W/ BLUE CAP NO. 18875 833.69'	EDGE G 1327 • 6 83R	7.03' D ST	2	3
SET 5/8" REBAR W/ BLUE CAP NO. 18875 N.E. COR. N.W. 1/4 N.E 1/4 SEC. B	E Set 5/8" reba Blue cap no.	DGE GRAVEL AR W/ 18875	DRAWNG	NOT TO SCALE
I hereby certify that the survey work was completed	<u>, </u>	List Corners t		HOT TO STATE
and this land surveying document was prepared by me or under my direct personal supervisor and that? am	Corners	Section	Twp	Ronge
a duly itensed land surveyor under the laws of the state of lowe Signature:	N.E. COR. N.W. 1/4 N.E. 1/4	8	84 NORTH	6 EAST
DOUGLAS M. CELLING HINKLE 18875				

PREPARED BY: PREPARED BY: HINKLE SURVEYING 1117 SPRINGBROOK LANE DEWITT, IA 52742 PHONE (563) 219-1087

Book 2018 Page 1251 Type 15 001 Pages 1 Date 4/23/2018 Time 3:15 PM Rec Amt \$7.00

ARLENE SCHAUF, RECORDER/REGISTRAR JACKSON COUNTY 10WA

UNITED STATES PUBLIC LAND SURVEY CORNER CERTIFICATE

·	OF			
Land Survey Monuments situated in Section 6 E, of the Fifth Principal I	8	, Township	84 N	_, Range
Previously recorded in N/A	Meridian,i	JACKSON n County Record	Coun	ty, lowa.
(Show reason for preparing this certificate, the evidence of positions and monumentation found or placed.) Monument Description and Remarks: SET 5/8" REBARCORNER AT THE CENTER OF THE INTERSECTION.	a, document num	ber, etc.) edures used in es AP NO. 18875 A	atablishing the con	
PREPARED CERTIFICATE BECAUSE NONE FOUND ON FIL	E AT THE RECO	ORDER'S OFFICE.		
JOB # 18-1986 DRURY FARM SURVEY 3	,			
ARROW SIGN MEASURED FROM THE NORTHEAST CORNER OF THE POST SET 5/8" REBAR W/ BLUE CAP NO, 18875 N. 1/4 COR. SEC. 8 SET MAG NAIL W/ SURVEY DISK IN POWER POLE	~~~~ € 83F	SURVEY	G NAIL W/ DISK IN ENCE POST	A N
I hereby certify that the survey work was completed and this land surveying document was prepared by me or under my direct personal supervison and that if am a duly licensed land surveyor under the laws of the state of laws	Corners N 1/4 CO	List Corners t Section OR. 8		NOT TO SCALE Range 6 EAST
Signature: DOUGLAS M HINKLE Date: 3/7/2018 Reg. No. 18875 My registration renewol date is December 31, 2019 SEAL DOUGLAS M. HINKLE 18875			OT WORK!	G EAS?

Document 19-3665

Type 15 001 Pages 1 Date 11/05/2019 Time 8:43 AM Rec Amt \$7.00

ARLENE SCHAUF, RECORDER/REGISTRAR JACKSON COUNTY TOWA

PREPARED BY: MICHAEL J. WEBER, WEBER SURVEYING, LLC, 26789 46TH AVE, BERNARD, IA 52032 (563) 879-4173

UNITED STATES PUBLIC LAND SURVEY CORNER CERTIFICATE

LAND SURVEY MONUMENTS SITUATED IN SECTION 8, TOWNSHIP 84 NORTH, RANGE 6 EAST OF THE FIFTH PRINCIPAL MERIDIAN, JACKSON COUNTY, IOWA. PREVIOUSLY RECORDED BK-1, PG-263


(Show reason for preparing this certificate, the evidence and detailed procedures used in establishing the corner positions and monumentation found or placed.) Monument Description and Remarks:

Chook, page, document number, etc.)

-SE COR., SEC. 8, T.84N. R.6E. OF THE 5TH P.M. FOUND 5/8' DIA REROD. ESTABLISHED NEW TIES -SOUTH 1/4 COR., SEC. 8, T.84N. R.GE. OF THE 5TH P.M. FOUND 5/8' DIA REROD. ESTABLISHED NEW TIES

(Show a minimum of three reference ties to durable physical objects, relevant manuments and physical conditions that will enable recovery of the corner.) PLAN - VIEW SET MAG NAIL IN YOP OF GAURDRAIL POST DRAWING NOT TO SCALE FOUND MAIL W/GREEN PLASTIC TAG IN WOOD Э9,₇₂, SET MAG NAIL IN TOP OF VOOD 64TH ST (GRAVEL) TZD9 SET MÁG NAIL IN 64TH ST (GRAVEL) POVER POLE SOUTH 1/4 COR., SEC. 8, T.84N, R.6E. OF THE 5TH P.M. FOUND 3/8' DIA. REROID SE COR., SEC. 8, T.84N, R.6E. OF THE 5TH P.M. FOUND 5/8' DIA. REROD

DWG. NO. 19113

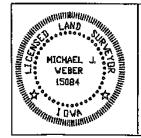

I HEREBY CERTIFY THAT THIS LAND SURVEYING DOCUMENT WAS PREPARED AND THE RELATED SURVEY WORK WAS PERFORMED BY ME OR UNDER MY DIRECT PERSONAL SUPERVISION AND THAT I AM A DULY

LICENSED LAND SURVEYOR UNDER THE LAVE OF THE STATE OF IOWA.

Which I July November 7, 2019 MICHAEL J. WEBER (DATE)

LICENSE NUMBER 15084

MY LICENSE RENEWAL DATE IS DECEMBER 31, 2019

THIS SHEET SHEETS COVERED BY THIS SEAL

List Corners to be Indexed Sec Twp Range Corner SE CDR. 8 84N 6E SOUTH 1/4 COR. 8 84N 6E

Document 19-3664

Type 15 001 Pages 1 Date 11/05/2019 Time 8:43 AM Rec Amt \$7.00

ARLENE SCHAUF, RECORDER/REGISTRAR JACKSON COUNTY IOWA


PREPARED BY MICHAEL J. WEBER, WEBER SURVEYING, LLC, 26789 46TH AVE, BERNARD, IA 52032 (563) 879-4173


UNITED STATES PUBLIC LAND SURVEY CORNER CERTIFICATE ΠF

LAND SURVEY MUNUMENTS SITUATED IN SECTION 8, TOWNSHIP 84 NORTH, RANGE 6 EAST OF THE FIFTH PRINCIPAL MERIDIAN, JACKSON COUNTY, IOWA. PREVIOUSLY RECORDED BK-1, PG-455, DOC. NO. 00-3866 Gook, page, document number, etc.)

(Show reason for preparing this certificate, the evidence and detailed procedures used in establishing the corner positions and monumentation found or placed.) Monument Description and Remarks

NE COR., SEC. 8, T.84N. R.6E. OF THE 5TH P.M. FOUND 5/8" DIA REROD. ESTABLISHED NEW TIES

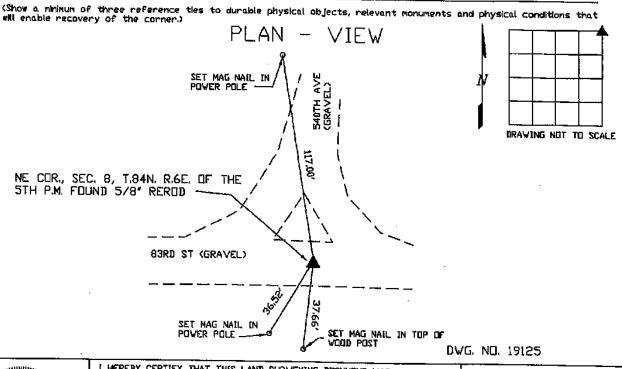

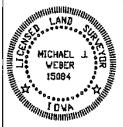

I HEREBY CERTIFY THAT THIS LAND SURVEYING DOCUMENT WAS PREPARED AND THE RELATED SURVEY WORK WAS PERFORMED BY ME OR UNDER MY DIRECT PERSONAL SUPERVISION AND THAT I AM A DULY SED LANDISURVEYOR UNDER THE LAWS OF THE STATE OF IDWA. WILLIAM WELL 12019

MICHAEL J. WEBER

(DATE)

LICENSE NUMBER 15084

MY LICENSE RENEWAL DATE IS DECEMBER 31, 2019

THIS SHEET SHEETS COVERED BY THIS SEAL I

List Corners to be Indexed

Corner

Sec Twp Range

NE COR.

84N 6E