
Prepared by Wn. Burger LandSurveyors

510 3rd Street West Court, Worthington, Iowa

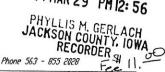

UNITED STATES PUBLIC LAND SURVEY CORNER CERTIFICATE

Land Survey Morum ents situated In Section 20, Township 85N, Range 4E, of the FIfth Principal

Meridian, Jackson County, Iowa, Previously recorded in N/A in the Office of the County Recorder

Monument Description and Remarks: (No Corner Certificates found at the County Recorders Office)

SW CORNER - SET 1/2' IRON ROD W/YELLOW LS CAP #12642 - USED INFORMATION FROM PLAT

LOCATED IN THE OFFICE OF THE JACKSON COUNTY RECORDER IN BOOK 1-G, PAGE 132


NW CORNER SW1/4 SW1/4 - SET 1/2' IRON ROD W/YELLOW LS CAP #12642 - SET ON LINE AND MIDWAY BETWEEN THE SW CORNER AND THE W1/4 CORNER

SE CORNER SW1/4 SW1/4 - SET 1/2' IRON ROD W/YELLOW LS CAP #12642 - SET ON LINE AND MIDWAY
BETWEEN THE SW CORNER AND THE S1/4 CORNER


NE CORNER SW1/4 SW1/4 - SET 1/2' IRON ROD W/YELLOW LS CAP #12642 - RUN STRAIGHT LINES FROM OPPOSITE 1/4 1/4 CORNERS AND SET AT POINT OF INTERSECTION

NOTE: METAL DETECTED ALL AREAS BUT NOTHING WAS FOUND, THERE IS NO PREVIOUS RECORD OF ANYTHING BEING SET AT ANY CORNER


PLAN VIEW

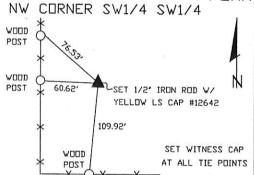


SW CORNER

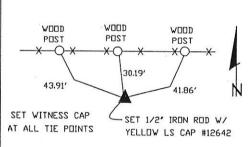

SE CORNER SW1/4 SW1/4

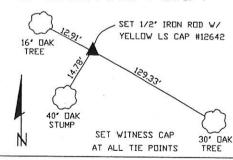

NE CORNER SW1/4 SW1/4

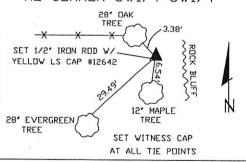



SEC. 20 TWP. 85N RANGE 4E

CORNERS TO BE INDEXED

50	85N	4E
20	85N	4E
20	85N	4E
20	85N	4E
	50	20 85N 20 85N



I hereby certify that this land surveying document was prepared and related survey work was performed by me or under my direct personal supervision and that I am a duly licensed Land Surveyor under the laws of the State of Iowa.

William H. Burger

License number 12642

My license renewal date is December 31, 2004 Pages or Sheets covered by this seal Sheet 1 of 1




Document 07-1383

Book 2 Page 552 Type 15 001 Pages 1 Date 3/26/2007 Time 11:29 AM Rec Amt \$7.00

ARLENE SCHAUF, RECORDER JACKSON COUNTY IOWA

PLAN - VIEW

(Show a minimum of three reference ties to durable physical objects, relevant monuments and physical conditions that will enable recovery of the corner.)

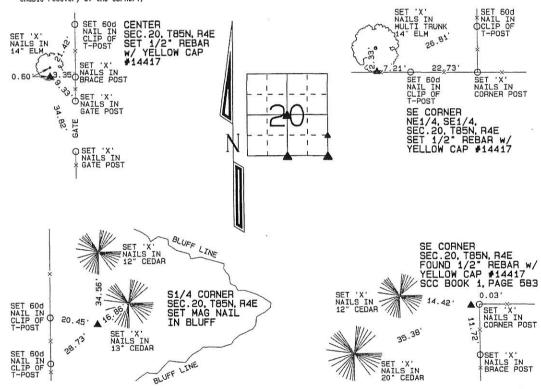

I hereby ca	rtify that this	land surveying	document was
prepared ar	d the related s	urvey work was	performed by
me or under	my direct pers	onal supervisio	n and that I
am a duly 1	icensed Land Su	rvevor under th	e laws of the
	wan In n	C VELOR PROPERTY PARTY PARTY	

David P. Schneider P.L.S. #14417 Date:
My license renewal date is December 31, 2007.

Pages or sheets covered by this seal: THIS SHEET ONLY

-	٠,	-1	E		-	u
U	U	11 4		LU	_	1

Land Surveying & Planning, Inc. P.O. Box 128 Farley, Iowa 52046 Ph. #563-744-3631 Fax#563-744-3629



List	Corners	to be Indexed	
Corners	Section	Тыр	Range
CENTER	20	85N	4E
S1/4 CORNER	20	85N	4E
SE CORNER NE1/4, SE1/4	20	85N	4E
SE CORNER	20	85N	4E

Bak 2 Page 552 JOB NO. 1005



Book 2 Page 657 Type 15 001 Pages 1 Date 2/09/2009 Time 11:05 AM Rec Amt \$7.00

ARLENE SCHAUF, RECORDER/REGISTRAR JACKSON COUNTY 10WA

Prepared by Wm. Burger LandSurveyor

510 3rd Street West Court, Worthington, Iowa

Phone 563 - 855 2028

TINTED CENTER DIDITE IAM CITATEV CODATED CEDENTAL AND

UNITED STATES PUBLIC LAND	SURVET CURNER CERTIFICATE
Meridian, Jackson County, Iowa. Previously recorded in Monument Description and Remarks: (No Corner	PMRShip 85N, Range 4E, of the Fifth Principal SEE NOTE in the Office of the County Recorder Certificates found at the County Recorders Office) SET ONLINE AND MIDWAY BETWEEN THE NW CORNER AND
NE CORNER - FD. MAG. NAIL IN CONCRETE ROAD	
NOTE: THE NE CORNER WAS PREVIOUSLY RECORDED IN	BOOK 1, PAGE 98
	<i>N VIEW</i> ne corner
N1/4 CORNER N1/4 CORNER N 73.74' A1.58' SET CUT 'X' SET CUT 'X' A1.58' COUNTY ROAD E17 45.27' SET CUT 'X' A1.58' A	FD. 'X' NAILS STOP SIGN STOP SIGN WITNESS DISK POWER POLE POLE POLE SET NAIL W/ WITNESS DISK WITNESS DISK WITNESS DISK WITNESS DISK WITNESS DISK
	CORNERS TO BE INDEXED
1201	N1/4 CORNER 20 85N 4E
	NE CORNER 20 85N 4E
SEC. 20 TWP. 85N RANGE 4E	
MINISTER STATE	I hereby certify that this land surveying document was prepar



and related survey work was performed by me or under my direct personal supervision and that I am a duly licensed Land Surveyor under the laws of the State of Iowa.

William H. Burger

License number 12642

My license renewal date is December 31, 2010 Pages or Sheets covered by this seal: Sheet 1 of 1

Book

Date