


Sec. 20

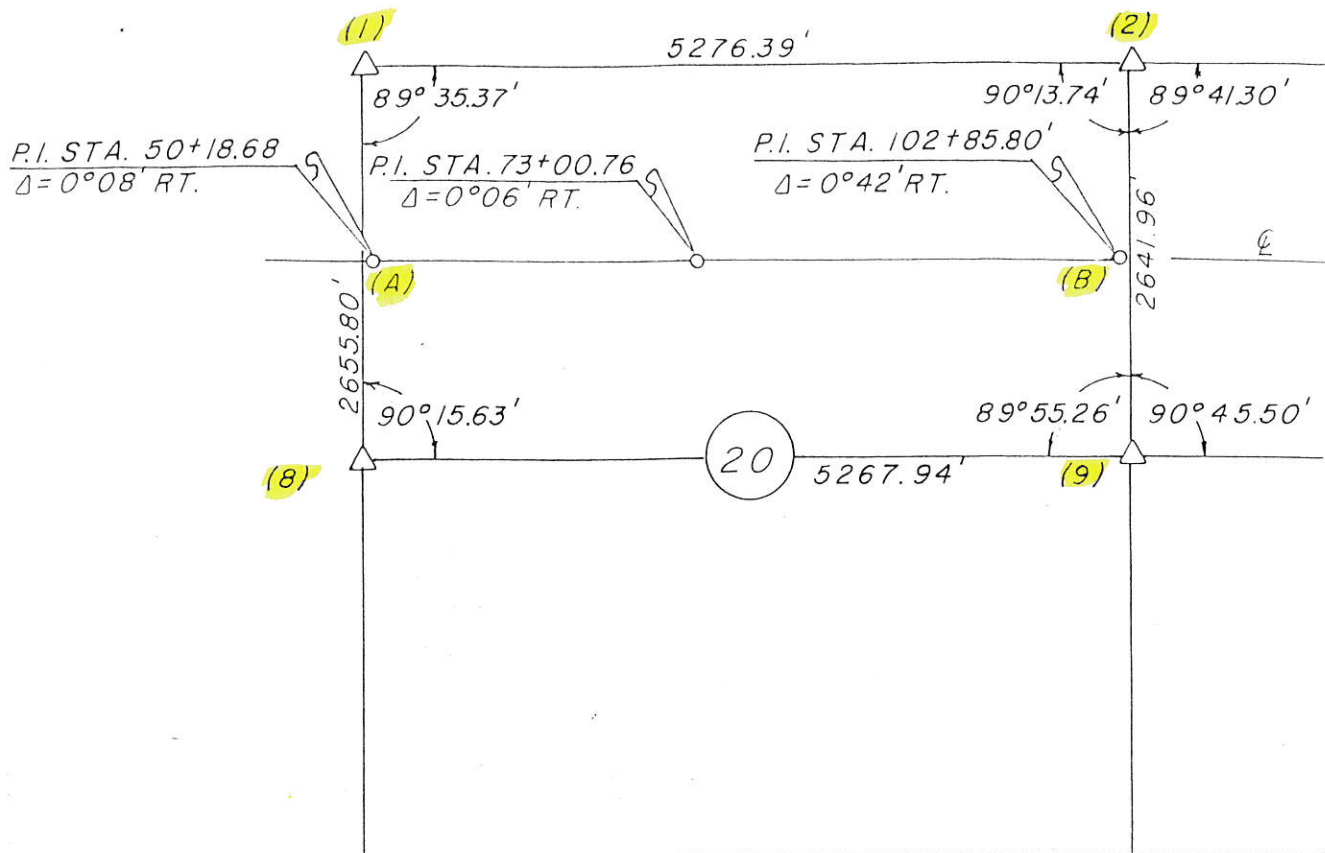

LAND CORNER SURVEY
JACKSON COUNTY
PROJ. NO. FN-64-2-(15)--21-49
T 84 N R 1 E







MADE FOR
IOWA DEPARTMENT OF TRANSPORTATION FOR
PURPOSE OF R.O.W. DESCRIPTION ON IA. HY 64
FROM MONMOUTH TO MAQUOKETA.

I HEREBY CERTIFY THAT THIS PLAT AND SURVEY
WERE MADE BY ME OR UNDER MY DIRECT PERSONAL
SUPERVISION AND THAT I AM A DULY REGISTERED
LAND SURVEYOR UNDER THE LAWS OF THE STATE
OF IOWA.

ASSISTED BY L.R. McGUIRE, D.L. STOOKEY, ROBERT NEMEC, M.C. HORST
AND JOHN REASONER

DATE FEB 26, 1979

John T. Boyce
JOHN T. BOYCE R.L.S. NO. 6805

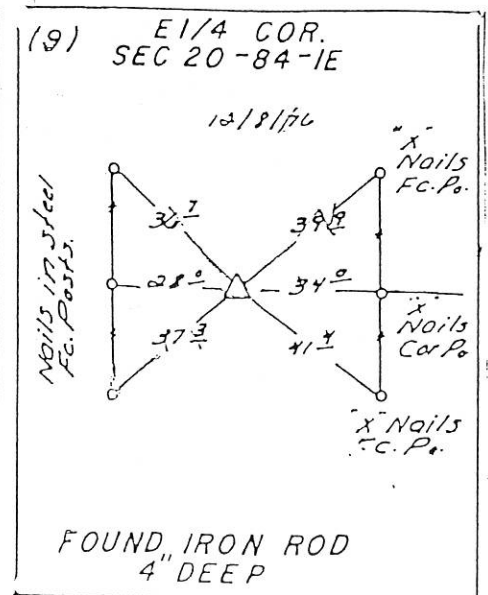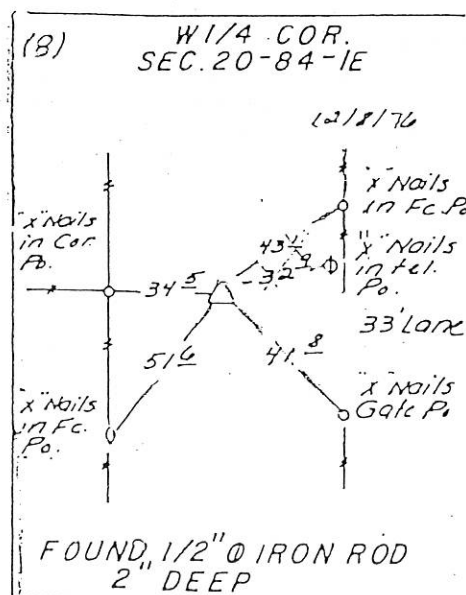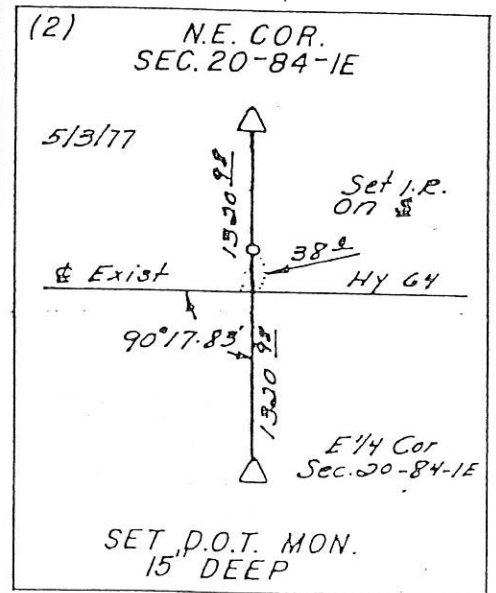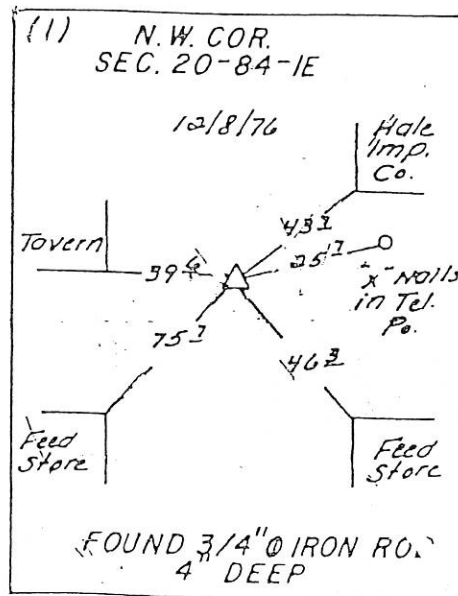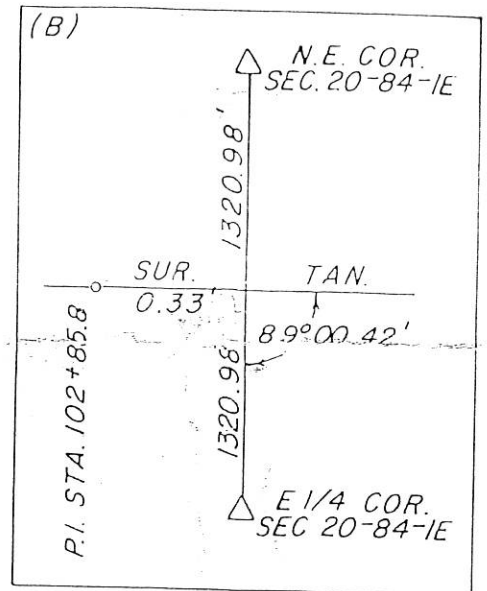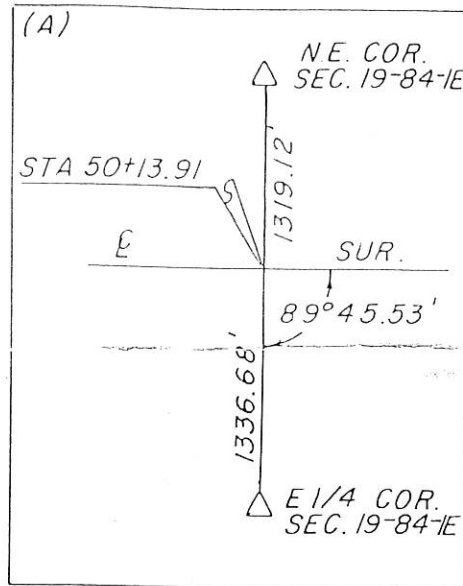



MONUMENT RECORD

JACKSON COUNTY, IOWA


SECTION 20 TOWNSHIP 84 N RANGE 1 E CORNER NW 1/4
EVIDENCE Used IDOT Ties found in Co. Engineers' Office - Used existing ties

MONUMENT: FOUND ☐ PLACED ☒

METHOD: ACCEPTED EXISTING LOCATION
ACCEPTED OCCUPATION
LOST CORNER PROPORTION METHODS
RE-ESTABLISHED FROM TIES

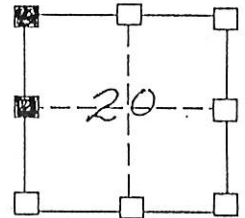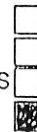

4-2-03 Corner Cert. in Bldg 33. cu # 03-1863
4-2-03 " " " " " " 33 cu # 03-1864

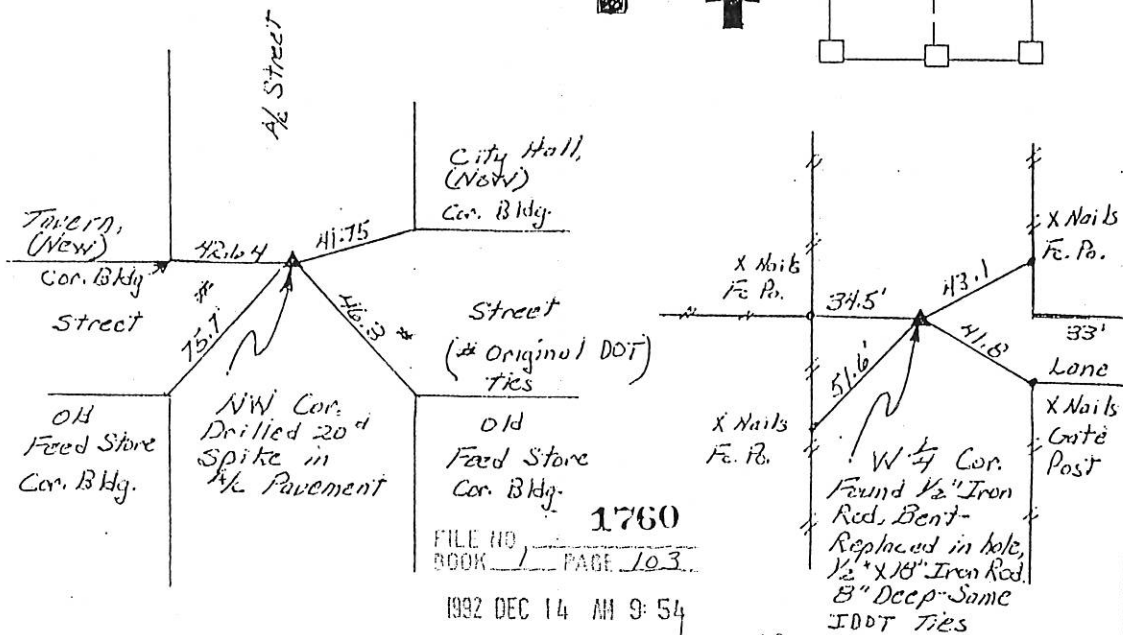

FILE NO. **1760**
BOOK 1 PAGE 103


1992 DEC 14 AM 9:54

SHIRLEY RITENOUR JLS.
JACKSON COUNTY, IOWA

HISTORY & OTHER INFORMATION IDOT Ties from 1976 found in Engineers Office

I hereby certify that this plat, map, survey or report was made by me, or under my direct personal supervision and that I am a duly registered Land Surveyor under the laws of the State of Iowa,
Signed _____ Date _____

William D. Upmeyer 12-8-92
WILLIAM D. UPMAYER L.S. Iowa Reg. No. 2869

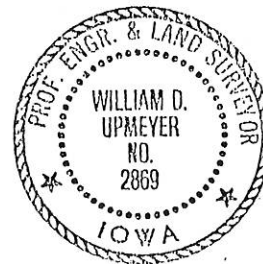

LEGEND

- △ GOVERNMENT CORNER
- — — EXISTING FENCE
- Ø POWER POLE

UPMEYER AND ASSOCIATES
LAND SURVEYING

404 S. Jones
Maquoketa, Iowa 52060
Phone: 652-2840

CORNER	SECTION	TWP.	RANGE
NW 1/4	20	84 N	1 E
NW	20	84 N	1 E



Document 13-3692

Book 3 Page 111 Type 15 001 Pages 1
Date 8/30/2013 Time 10:49 AM
Rec Amt \$7.00

ARLENE SCHAUF, RECORDER/REGISTRAR
JACKSON COUNTY IOWA


Prepared by: SCHNEIDER Land Surveying and Planning, Inc. P.O. Box 128 Farley, Iowa 52046 563-744-3631

UNITED STATES PUBLIC LAND SURVEY CORNER CERTIFICATE OF

Land Survey Monuments situated in Section 20, Township 84 North, Range 1 East
of the Fifth Principal Meridian, Jackson County, Iowa.
Previously recorded (NONE OF RECORD)

Monument Description and Remarks: A 1/2" REBAR AND 'X' NAILS FOR REFERENCE TIES WERE FOUND AT THE
CENTER OF SECTION 20, T84N, R1E. NO RECORD OF THE 1/2" REBAR WAS FOUND, BUT THE LOCATION MATCHED THE OCCUPATION
EVIDENCE AND THE MONUMENT WAS ACCEPTED AS THE CORNER AND RETIED.

PLAN - VIEW

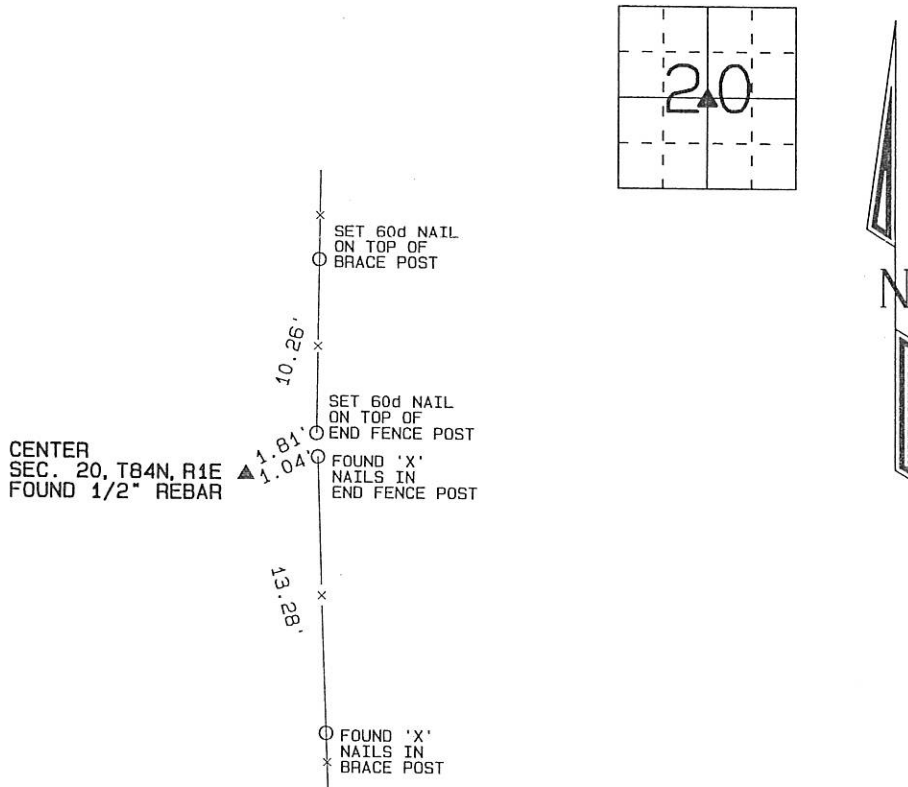

I hereby certify that this land surveying document was prepared and the related survey work was performed by me or under my direct personal supervision and that I am a duly licensed Land Surveyor under the laws of the State of Iowa.

David P. Schneider P.L.S. #14417


Date:

License renewal date is December 31, 2013.

Surveys or sheets covered by this seal: THIS SHEET ONLY

SCHNEIDER
Land Surveying & Planning, Inc.

P.O. Box 128 Farley, Iowa 52046
Ph. #563-744-3631 Fax #563-744-3629

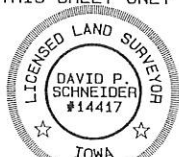

List Corners to be Indexed

Corners	Section	Twp	Range
CENTER	20	84N	1E