UNITED STATES PUBLIC LAND SURVEY CORNER CERTIFICATE

OF

LAND SURVEY MONUMENTS SITUATED IN SECTION 29 ,TOWNSHIP 85 NORTH , RANGE 3 EAST OF THE FIFTH PRINCIPAL MERIDIAN, JACKSON COUNTY, IOWA. PREVIOUSLY RECORDED IN
(Show reason for preparing this certificate, the evidence and detailed procedures used in establishing the corner positions and manumentation found or placed.)
Monument Description and Remarks:
NORTH 1/4 CORNER, SECTION 29, T85N, R3E - SET #5 REROD WITH CAP 12631 IN CENTERLINE
OF ROAD AT MIDPOINT BETWEEN N.W. COR. AND N.E. COR, SEC. 29, NO MONUMENT FOUND
PLAN — VIEW (Show a minimum of three reference ties to durable physical objects, relevant monuments and physical conditions that will enable recovery of the corner.)
OD1867 FILE NO BOOK PAGE 256 1996 JAN 10 AM 9: 49 SHIRLY RITEHOUR JACKSON COUNTY, IDWA RECORDER CLUB®
SET "X" NAILS IN TOP OF FENCE POST SET "X" NAILS IN COR. POST SET ROD N 1/4 COR, SEC. 29
(CRUSHED ROCK ROAD)
SET "X" NAILS IN TOP OF END POST JOHN M. TRANMER 12631
Emple 1
HEREBY CERTIFY THAT THE SURVEY WORK WAS COMPLETED AND THIS CERTIFICATE WAS PREPARED BY ME OR UNDER MY DIRECT PERSONAL SUPERMISION AND THAT I AM A DULY REGISTERED LAND SURVEYOR UNDER THE LAWS OF THE STATE OF IOWA. JOHN M. TRANMER JOHN M. TRANMER MY REGISTRATION EXPIRES DECEMBER 31, 1996
ENGINEERS AND SURVEYORS P.C. Iowo, Illinole, Maconsin 4155 Pennsylvania Ave. Dubuque, Ia. 52002 (319) 558-2484 Cube City, M. Colena, II. M.

531-13 See Corner Certificate in 1800k 3 Page 89 # 13-2197

UNITED STATES PUBLIC LAND SURVEY CORNER CERTIFICATE

JOHN M. TRANNER REG. NO. 12831	OF ,
Cover a molecular of breather than the evidence and debated procedures used in establishing the corner positions and monumentation found to proceed. MONUMENT Description and Remarks: NW CORNER, SECTION 29, T85N, R3E — FOUND #4 REROD AT CENTERLINE INTERSECTION NE CORNER, SECTION 29, T85N, R3E — SET #5 REROD WITH CAP 12631 AT CENTERLINE INTERSECTION, NO MONUMENT FOUND. PLAN — VIEW (Show a molecular of breast reference tites to durable physical depictar, referend monuments and physical conditions that will anable recovery of the content of the second physical conditions that will anable recovery of the content of the second physical conditions that will anable recovery of the content of the second physical conditions that will anable recovery of the content of the second physical conditions that will anable recovery of the content of the second physical conditions that will anable recovery of the content of the second physical conditions that will anable recovery of the content of the second physical conditions that will anable recovery of the content of the second physical conditions that will anable recovery of the content of the second physical conditions that will anable recovery of the content of the second physical conditions that will anable recovery of the content of the second physical conditions that will anable recovery of the content of the second physical conditions that will anable recovery of the content of the second physical conditions that will anable recovery of the content of the second physical conditions that will anable recovery of the content of the second physical conditions that will anable recovery of the content of the second physical conditions that will anable recovery of the content of the second physical conditions that will anable recovery of the content of the second physical conditions that will anable recovery of the content of the second physical anable physical phys	OF THE FIFTH PRINCIPAL MERIDIAN, JACKSON COUNTY, IOWA.
MW CORNER, SECTION 29, T85N, R3E — FOUND #4 REROO AT CENTERLINE INTERSECTION NE CORNER, SECTION 29, T85N, R3E — SET #5 REROO WITH CAP 12831 AT CENTERLINE INTERSECTION, NO MONUMENT FOUND. PLAN — VIEW (Corner a minimum of three reference ties to durable physical deplects, redecent measurements and physical conditions that will enable recovery of the corner.) SET "X" NAILS IN STOP SIGN POST SET "X" NAILS IN STOP SIGN POST SET "X" NAILS IN TOP OF GATE POST AN A FOUNDATION FOR THE BURNEY WING WING CONFIETED AND THIS CORNER SEC. 29 134th STREET COR, OF EX. STEEL STREET SIGN POST NE. COR, SEC. 29 134th STREET COR, OF EX. STEEL STREET SIGN POST NE. COR, SEC. 29 134th STREET COR, OF EX. STEEL STREET SIGN POST NE. COR, SEC. 29 134th STREET COR, OF EX. STEEL STREET SIGN POST NE. COR, SEC. 29 134th STREET CORD OF EX. STEEL STREET SIGN POST NE. COR, SEC. 29 134th STREET CORD OF EX. STEEL STREET SIGN POST NE. COR, SEC. 29 134th STREET CORN. OF EX. STEEL CORN. OF EX. STEEL STREET SIGN POST NE. CORN. SEC. 29 134th STREET SIGN POST NE. CORN. SEC. 29 134th STREET SIGN POST NE. CORN. SEC. 29 134th STREET CORN. SEC. 29 134th STREET CORN. SEC. 29 134th STREET SIGN POST NE. CORN. SEC. 29 134th STREET CORN. SEC. 29 134th STREET CORN. SEC. 29 134th STREET SIGN POST NE. CORN. SEC. 29 134th STREET SIGN POST NE. CORN. SEC. 29 134th STREET CORN. SEC. 29 134th STREET SIGN POST NE. CORN. SEC. 29 134th STREET SIGN POST SIGN POST NE. CORN. SEC. 29 SIGN P	
NW CORNER, SECTION 29, T85N, R3E — FOUND #4 REROD AT CENTERLINE INTERSECTION NE CORNER, SECTION 29, T85N, R3E — SET #5 REROD WITH CAP 12631 AT CENTERLINE INTERSECTION, NO MONUMENT FOUND. PLAN — VIEW (Chow a minimum of three reference lies to durchle physical objects, relevant monuments and physical conditions that will enable recovery of the corner.) SET "X" NAILS IN STREET STOP OF GATE POST SET "X" NAILS IN TOP OF GATE POST SET "X" NAILS IN FOWER POLE SET "X" NAILS IN TOP OF GATE POST SET ROO W/ CAP 12631 N.E. COR, SEC. 29 SET ROO W/ CAP 12631 N.E. COR, SEC. 29 SET ROO W/ CAP 12631 N.E. COR, SEC. 29 SET ROO W/ CAP 12631 N.E. COR, SEC. 29 SET TX" NAILS IN TOP OF GATE POST SET ROO W/ CAP 12631 N.E. COR, SEC. 29 SET ROO W/ CAP 12631 N.E. COR, SEC. 29 SET ROO W/ CAP 12631 N.E. COR, SEC. 29 SET ROO W/ CAP 12631 N.E. COR, SEC. 29 SET ROO W/ CAP 12631 N.E. COR, SEC. 29 SET ROO W/ CAP 12631 N.E. COR, SEC. 29 SET ROO W/ CAP 12631 N.E. COR, SEC. 29 SET ROO W/ CAP 12631 N.E. COR, SEC. 29 SET ROO W/ CAP 12631 N.E. COR, SEC. 29 SET ROO W/ CAP 12631 N.E. COR, SEC. 29 SET ROO W/ CAP 12631 N.E. COR, SEC. 29 SET ROO W/ CAP 12631 N.E. COR, SEC. 29 SET ROO W/ CAP 12631 N.E. COR, SEC. 29 SET ROO W/ CAP 12631 N.E. COR, SEC. 29 SET ROO W/ CAP 12631 N.E. COR, SEC. 29 SET ROO W/ CAP 12631 N.E. COR, SEC. 29 SET ROO W/ CAP 12631 N.E. COR, SEC. 29 SET ROO W/ CAP 12631 N.E. COR, SEC. 29	
NE CORNER, SECTION 29, 185N, R3E — SET #5 REROD WITH CAP 12631 AT CENTERLINE INTERSECTION, NO MONUMENT FOUND. PLAN — VIEW (Show a mibimum of three reterence ties to durable physical objects, relevant monuments and physical conditions that will enable recovery of the control	monument Description and Remarks:
NE CORNER, SECTION 29, 185N, R3E — SET #5 REROD WITH CAP 12631 AT CENTERLINE INTERSECTION, NO MONUMENT FOUND. PLAN — VIEW (Show a mibimum of three reterence ties to durable physical objects, relevant monuments and physical conditions that will enable recovery of the control	NW CORNER SECTION 29 TREN PRE FOUND #4 DEPOR AT SECTION 29
SET "X" NAILS IN TOP OF GATE POST SET "X" NAILS IN TOP OF GATE POST N.E. COR, SEC. 29 1.34th STREET SET "X" NAILS IN TOP OF GATE POST N.E. COR, SEC. 29 1.34th STREET SET "X" NAILS IN TOP OF GATE POST SET "X" NAILS IN T	NE CORNER, SECTION 29, T85N, R3E - SET #5 REROD WITH CAP 12631 AT CENTERLINE INTERSECTION
Glow a millerum of three reference ties to durable physical objects, relevant monuments and physical conditions that will enable recovery of the connect. SET ST ANALS IN STREET SET "X" NAILS IN STOP SIGN POST SET "X" NAILS IN TOP OF GATE POST SET "X" NAILS	NO MONUMENT FOUND.
Glow a millerum of three reference ties to durable physical objects, relevant monuments and physical conditions that will enable recovery of the connect. SET ST ANALS IN STREET SET "X" NAILS IN STOP SIGN POST SET "X" NAILS IN TOP OF GATE POST SET "X" NAILS	
SET "X" NAILS IN TOP OF GATE POST NN.E. COR, SEC. 29 LIST CORNERS TO BE RIDEDED CONNESS SECTION TOP RAINE SECTION TOP RAINE SET "X" NAILS IN TOP OF GATE POST SET "X" NAILS IN TOP OF GATE POST SET "X" NAILS IN TOP OF GATE POST NN.E. COR, SEC. 29 LIST CORNERS TO BE RIDEDED CONNESS SECTION TOP RAINE SECTION TOP RAINE SET "X" NAILS IN TOP OF GATE POST NN.E. COR, SEC. 29 LIST CORNERS TO BE RIDEDED CONNESS SECTION TOP RAINE SET "X" NAILS IN TOP OF GATE POST NN.E. COR, SEC. 29 LIST CORNERS TO BE RIDEDED CONNESS SECTION TOP RAINE SET "X" NAILS IN TOP OF GATE POST NN.E. COR, SEC. 29 LIST CORNERS TO BE RIDEDED CONNESS SECTION TOP RAINE CONNESS SECTION T	PLAN — VIEW
SET "X" NAILS IN TOP OF GATE POST SET "X" NAILS IN	corner.)
SET "X" NAILS IN STOP SIGN POST SET "X" NAILS IN STOP OF GATE POST SET "X" NAILS IN TOP OST SET "X" NAILS I	FND ROD N.W. COR. SEC. 29
SET "X" NAILS IN TOP OF GATE POST SET ROD W/ CAP 12631 N.E. COR, SEC. 29 SET "X" NAILS IN TOP OF GATE POST SET ROD W/ CAP 12631 N.E. COR, SEC. 29 IND SCALE SET "X" NAILS IN TOP OF GATE POST SET ROD W/ CAP 12631 N.E. COR, SEC. 29 IND SCALE SET "X" NAILS IN TOP OF GATE POST SET ROD W/ CAP 12631 N.E. COR, SEC. 29 IND SCALE SET "X" NAILS IN TOP OF GATE POST SET ROD W/ CAP 12631 N.E. COR, SEC. 29 IND SCALE SET "X" NAILS IN TOP OF GATE POST SET ROD W/ CAP 12631 N.E. COR, SEC. 29 IND SCALE SET "X" NAILS IN TOP OF GATE POST SET ROD W/ CAP 12631 N.E. COR, SEC. 29 IND SCALE SET "X" NAILS IN TOP OF GATE POST SET ROD W/ CAP 12631 N.E. COR, SEC. 29 IND SCALE SET ROD W/ CAP 126	CRUSHED ROCK ROAD)
SET "X" NAILS IN TOP OF GATE POST 134th STREET SET "X" NAILS IN TOP OF GATE POST 12.08' SET ROD W/ CAP 12631 N.E. COR, SEC. 29 FND ROD 134th STREET COR. OF EX. STEEL STREET SIGN POST STREET SIGN POST OUT POLE NO SCALE LIST CORNERS TO BE INDEXED CORNERS SECTION TWP RANCE N.W. COR. 29 TESH R.W. COR. N.W. COR. 29 TESH R.W. CO	
134th STREET 12.08' COR. OF EX. STEEL STREET SIGN POST COR. OF EX. STEEL STREET SIGN POST SET "X" NAILS IN POWER POLE NO SCALE LIST CORNERS TO BE INDEXED CORNERS LIST CORNERS TO BE INDEXED CORNERS SECTION THP RANGE CORNERS SECTION THP RANGE N.W. COR. 29 TISSN R.W. LOVID MY REGISTRATION EXPERSED BLOCKHIBER 31, 1996 ENGINEERS AND SURVEYORS P.C. LOVE, Jillinois, Wisconsin LIST CORNERS TO BE INDEXED CORNERS SECTION THP RANGE N.W. COR. 29 TISSN R.W. TRANMER 12.29 SURVEYORS P.C. COVIN MY REGISTRATION EXPERS DECEMBER 31, 1996 ENGINEERS AND SURVEYORS P.C. LOVE, Jillinois, Wisconsin LIST CORNERS TO BE INDEXED CORNERS SECTION THP RANGE N.W. COR. 29 TISSN R.W. TRANMER 10.011 JOHN M. TRANMER 12.29 SURVEYORS P.C. TOWNSHIP: DATE: DATE: 10.011 DATE: DATE: 10.011 PERRY DIVIDING DIVIDING DIVIDING DIVIDING DIVIDING DIVIDING DIVIDING DIVIDING DATE: 10.011 DATE: DATE: 10.011 DATE: DATE: 10.011 DATE: DATE: 10.011 DATE: DATE: DATE: 10.011 DATE:	
THEREBY CERTIFY THAT THE SURVEY WORK WAS COMPLETED AND THIS CERTIFICATE AM A DULLY REGISTERED LAND SURVEY WORK WAS COMPLETED AND THIS CERTIFICATE AM A DULLY REGISTERED LAND SURVEY WORK WAS COMPLETED AND THIS CERTIFICATE AM A DULLY REGISTERED LAND SURVEY WORK WAS COMPLETED AND THIS CERTIFICATE AM A DULLY REGISTERED LAND SURVEY SINCE OF THE LANS OF THE STATE OF	× × × × × × × × × × × × × × × × × × ×
SET "X" NAILS IN POWER POLE HEREBY CERTIFY THAT THE SURVEY WORK WAS COMPLETED AND THIS CERTIFICATE WAS PREPARED BY ME OR UNDER MY DIRECT PERSONAL SUPERWISION AND THAT AM A DULY REGISTERED LAND SURVEYOR UNDER THE LAWS OF PERSONAL SUPERWISION AND THAT AM A DULY REGISTERED LAND SURVEYOR UNDER THE LAWS OF PERSONAL SUPERWISION AND THAT AM A DULY REGISTERED LAND SURVEYOR UNDER THE LAWS OF PERSONAL SUPERWISION AND THAT AM A DULY REGISTERED LAND SURVEYOR UNDER THE LAWS OF PERSONAL SUPERWISION AND THAT AM A DULY REGISTERED LAND SURVEYOR UNDER THE LAWS OF PERSONAL SUPERWISION AND THAT AM A DULY REGISTERED LAND SURVEYOR UNDER THE LAWS OF PERSONAL SUPERWISION AND THAT AM A DULY REGISTERED LAND SURVEYOR UNDER THE LAWS OF PERSONAL SUPERWISION AND THAT AM A DULY REGISTERED LAND SURVEYOR UNDER THE LAWS OF CORNERS SECTION TWP RANGE N.W. COR. 29 TBSN R3E THE CORNERS TO BE INDEXED CORNERS SECTION TWP RANGE N.W. COR. 29 TBSN R3E THE CORNERS TO BE INDEXED CORNERS SECTION TWP RANGE N.W. COR. 29 TBSN R3E TO WASHINGTON TO THE CORNERS TO BE INDEXED CORNERS SECTION TWP RANGE N.W. COR. 29 TBSN R3E TO WASHINGTON TO THE CORNERS TO BE INDEXED CORNERS SECTION TWP RANGE N.W. COR. 29 TBSN R3E TO WASHINGTON TO THE CORNERS TO THE CORNERS	134th STREET 23 12.08'
HEREBY CERTIFY THAT THE SURVEY WORK WAS COMPLETED AND THIS CERTIFICATE AN A DULY REGISTERED LAND SURVEYOR UNDER THE LAWS OF THE STATE CORNERS SECTION TWP RANGE AN A DULY REGISTERED LAND SURVEYOR UNDER THE LAWS OF THE STATE CORNERS JOHN M. TRANMER AND SURVEYORS DATE: LIST CORNERS TO BE INDEXED CORNERS SECTION TWP RANGE N.W. COR. 29 T85N R3E N.E. COR. 29 T85N R3E DATE: LOW N.E. COR. 29 T85N R3E N.E.	SET "X" NAILS *
AND PREPARED BY ME OR UNDER MY DIRECT PERSONAL SUPERSONAL SUPERSON	NO SCALE
ENGINEERS AND SURVEYORS P.C. Iowa, Illinois, Wisconsin 4155 Pennsylvania Ava. Dubuque, Ia. 52002 Gultenberg, IA. Colons, II. DATE: 12/4/95 FIELD PROJ. INDEX	MAS PREPARED BY ME OR UNDER MY DIRECT PERSONAL SUPERVISION AND THAT ITS CORNERS AND DILY REGISTERED LAND SURVEYOR UNDER THE LAWS OF THE STATE OF JOWA. JOHN M. TRANMER DATE: MY REGISTRATION EXPIRES DECEMBER 31, 1996 DATE: 12631 DATE: 12631
TROOK NO 711 IN INCENSED.	ENGINEERS AND SURVEYORS P.C. Lowd, Illinois, Wisconsin 4155 Pennsylvania Ave. Dubuque, Ia. 52002 DATE: 12/4/95 FIELD PROJ. INDEX

1 | 1441 | 114 | 115 | 115 | 115 | 115 | 115 | 115 | 115 | 115 | 115 | 115 | 115 | 115 | 115 | 115 | 115 | 115

Book 3 Page 89 Type 15 001 Pages 1 Date 5/31/2013 Time 11:45 AM Rec Amt \$7.00

ARLENE SCHAUF, RECORDER/REGISTRAR JACKSON COUNTY 10WA

PREPARED BY MICHAEL J. WEBER, WEBER SURVEYING, LLC, 26789 46TH AVE, BERNARD, IA 52032 (563) 879-4173


UNITED STATES PUBLIC LAND SURVEY CORNER CERTIFICATE ΠF

LAND SURVEY MONUMENTS SITUATED IN SECTION 29, TOWNSHIP 85 NORTH, RANGE 3 EAST OF THE FIFTH PRINCIPAL MERIDIAN, JACKSON COUNTY, IOWA. PREVIOUSLY RECORDED SEE NOTES BELOW Goods, page, document number, etc.


(Show reason for preparing this certificate, the evidence and detailed procedures used in establishing the corner positions and monumentation found or placed.) Monument Description and Remarks

-NE COR., SEC. 29 T.85N. R.3E. OF THE 5TH P.M. FOUND $5/8^{\prime\prime}$ STEEL ROD, W/RED CAP NO. 12631 PER SEC. COR. CERT. BK 1 PG 257. ESTABLISHED NEW TIES.

-N 1/4 CDR., SEC. 29 T.85N. R.3E. DF THE 5TH P.M. FDUND 5/8" STEEL RDD, PER SEC. CDR. CERT. BK 1 PG 256, ESTABLISHED NEW TIES.

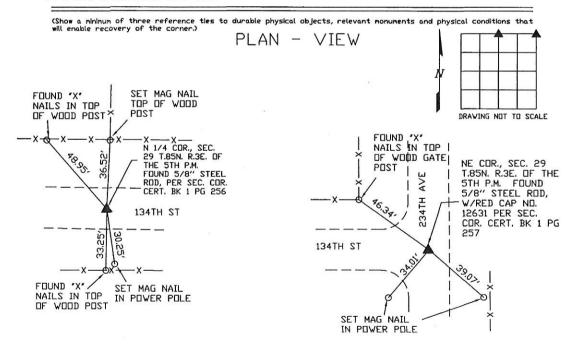

DWG. NO. 13028

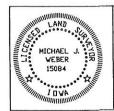

I HEREBY CERTIFY THAT THIS LAND SURVEYING DOCUMENT WAS I HEREBY CERTIFY THAT THIS LAND SURVEYING DOCUMENT WAS PREPARED AND THE RELATED SURVEY WORK WAS PERFORMED BY ME OR UNDER MY DIRECT PERSONAL SUPERVISION AND THAT I AM A DULY LICENSED LAND SURVEYING UNDER THE LAWS OF THE STATE OF IDWA.

MICHAEL J. WEBER (DATE)

LICENSE NUMBER 15084

MY LICENSE RENEWAL DATE IS DECEMBER 31, 2013 THIS SHEET

SHEETS COVERED BY THIS SEAL ._

List Corners to be Indexed Corner Sec Twp Range

29 85N 3E NE COR N 1/4 COR 29 85N 3E