

UNITED STATES PUBLIC LAND SURVEY CORNER CERTIFICATE

SLS19-90

OF





Land Survey Monuments situated in Section 24, Township 87N, Range 3E, of the Fifth Principal Meridian, JACKSON County, Iowa.
Previously recorded in NOT PREVIOUSLY RECORDED in County Recorder's Office.

(Show reason for preparing this certificate, the evidence and detailed procedures used in establishing the corner positions and monumentation found or placed.)

Monument Description and Remarks: The NE Corner Of Section 24 And The SW Corner Of The NW 1/4 Of The NE 1/4 Of Section 24 Were Set Using Fence Lines. The NW Corner Of The NE 1/4 By Using Quarter Section Fence Line Dimensions. The NE Corner And SE Corners Of The NW 1/4 Of The NE 1/4 Were Set By Using The Intersected Quarter Section Fence Line Dimensions. No Corners Were Found

PLAN - VIEW


(Show a minimum of three reference ties to durable physical objects, relevant monuments and physical conditions that will enable recovery of the corner.)

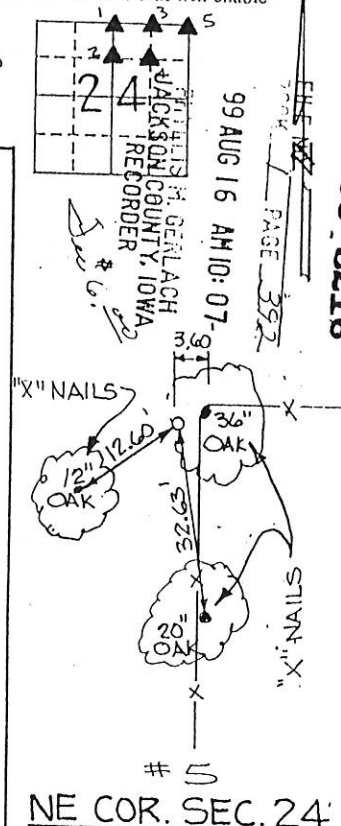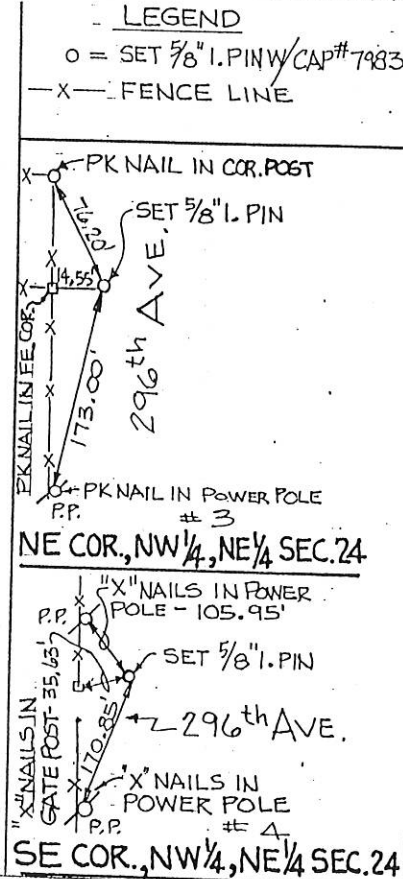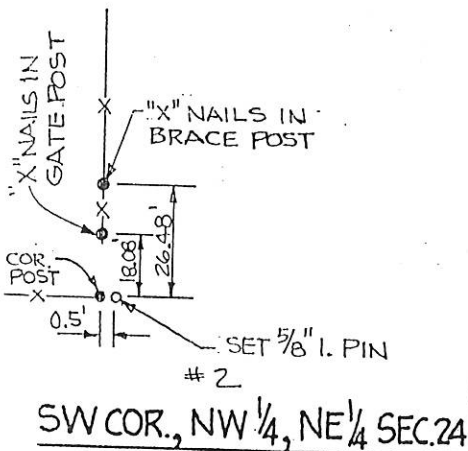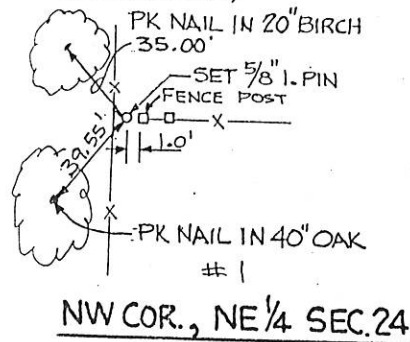

I hereby certify that the survey work was completed and this certificate was prepared by me or under my direct personal supervision and that I am a duly registered land surveyor under the laws of the state of Iowa.

Signature: James L. Egger
Name typed or printed: JAMES L. EGGER
Date: Aug 13, 1999 Reg. No. 7983

SEAL

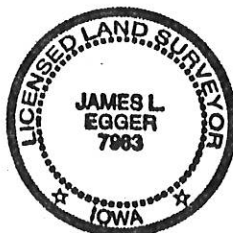

Corners	Section	Twp	Range
NE	24	87N.	3E.
SE	13	87N.	3E.
NE, NW 1/4, NE 1/4	24	87N.	3E.
SE, SW 1/4, SE 1/4	13	87N.	3E.
SE, NW 1/4, NE 1/4	24	87N.	3E.
SW, SE 1/4	13	87N.	3E.
SW, NW 1/4, NE 1/4	24	87N.	3E.
NW, NE 1/4	24	87N.	3E.

UNITED STATES PUBLIC LAND SURVEY CORNER CERTIFICATE

OF


Land Survey Monuments situated in Section 24, Township 87 N, Range 3E, of the Fifth Principal Meridian, Jackson County, Iowa. Previously recorded in N/A in County Recorder's Office.

(Show reason for preparing this certificate, the evidence and detailed procedures used in establishing the corner positions and monumentation found or placed.)

Monument Description and Remarks: The NE Corner of the NW 1/4 of the SE 1/4 was set by intersecting the East/West fence line with the distance split of 296th Ave. Easement fences. The SE Corner of the SW 1/4 of the SE 1/4 was set using the above mentioned method. The SW Corner of the SE 1/4 was set by using a prorated distance between a line fence to the West and the previously set SE Cor. of the SW 1/4 of the SE 1/4, extending the South fence line the correct distance. The NE Corner of the SE 1/4 of the SW 1/4 was set by finding evidence of an ancient fence corner.

PLAN - VIEW

(Show a minimum of three reference ties to durable physical objects, relevant monuments and physical conditions that will enable recovery of the corner.)

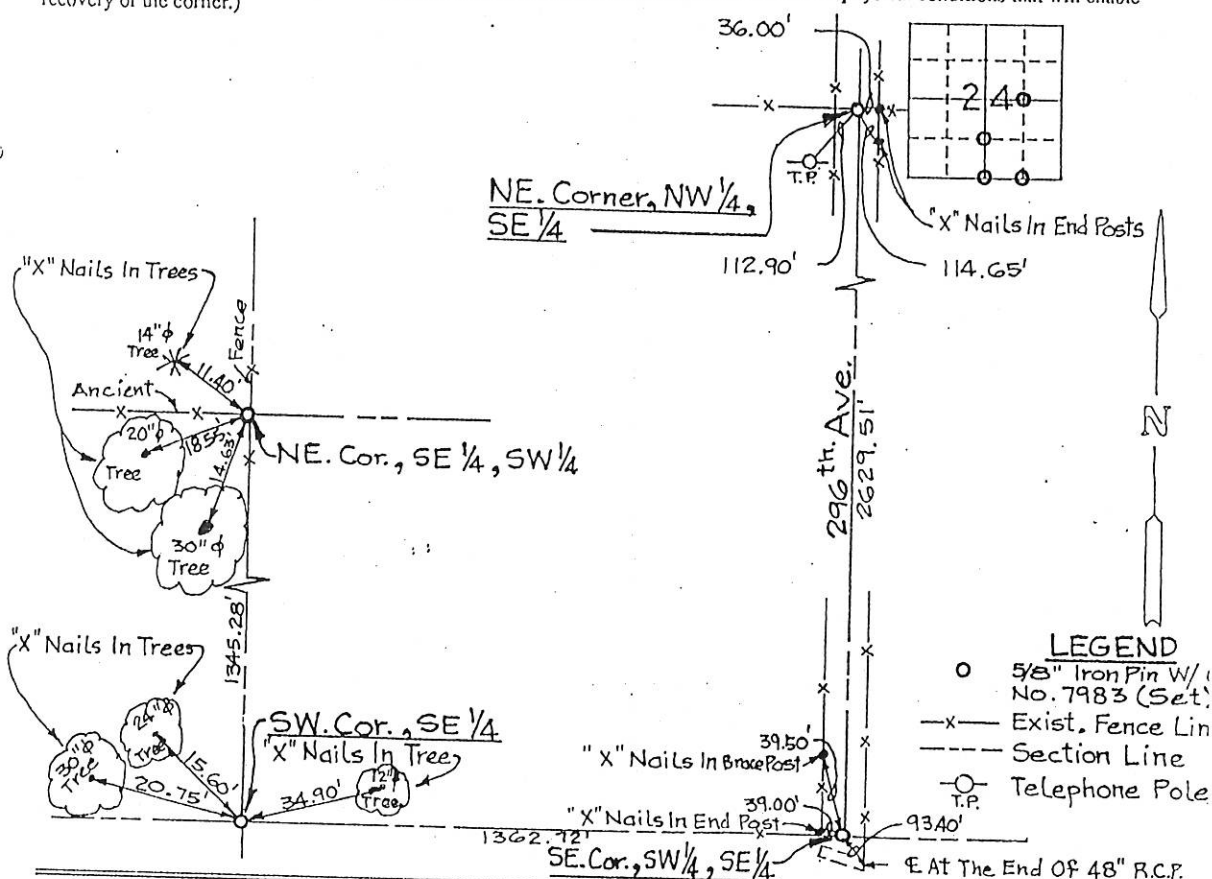


I hereby certify that the survey work was completed and this certificate was prepared by me or under my direct personal supervision and that I am a duly registered land surveyor under the laws of the state of Iowa.

Signature: James L. Egger
Name typed or printed: JAMES L. EGGER
Date: Mar 24, 2000 Reg. No. 7983

Date: Mar 24, 2000 Reg. No. 7983

Corners	Section	Twp	Range
NE., NW $\frac{1}{4}$, SE $\frac{1}{4}$.	24	87 N.	3E.
NE., SE $\frac{1}{4}$, SW $\frac{1}{4}$.	24	87 N.	3E.
SW, SE $\frac{1}{4}$	24	87 N.	3E.
NW, NE $\frac{1}{4}$	25	87 N.	3E.
SE., SW $\frac{1}{4}$, SE $\frac{1}{4}$	24	87 N.	3E.
NE., NW $\frac{1}{4}$, NE $\frac{1}{4}$	25	87 N.	3E.

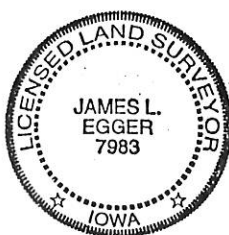

SEAL

4-3-03 See serial certificate in Book 2 Page 66 as file # 03-1928

00 0979
FILE NO. 1
MAR 28 PM 12:37
JACKSON COUNTY, IOWA
RECORDED

26 1100

FILE NO 03-1928
BOOK 2 PAGE 66

03 APR -3 AM 7:30

PHYLLIS M. GERLACH
JACKSON COUNTY, IOWA
RECORDER

Fee 6.00

Preparer's Name: Paul C. Brashaw Address: 4413 West Stagecoach Trail Galena, Ill. Telephone: 777-1172

SLSI 9-94

UNITED STATES PUBLIC LAND SURVEY CORNER CERTIFICATE

OF

Land Survey Monuments situated in Section 24, Township 87 NORTH, Range 3 EAST, of the Fifth Principal Meridian, JACKSON County, Iowa.
Previously recorded in Book 1, Page 424 in County Recorder's Office.
(book, page, document number, etc.)

(Show reason for preparing this certificate, the evidence and detailed procedures used in establishing the corner positions and monumentation found or placed.)


Monument Description and Remarks: SE CORNER OF THE SW 1/4 OF THE
NE 1/4 OF SECTION 24, T87N, R3E, SET 5/8" X 36"
IRON ROD WITH ORANGE CAP NO 10134, ESTABLISHED
BY EXTENSION OF LINE FROM JAMES L EGGER, NO 7983 FROM
1/4 1/4 CORNERS TO THE NORTH AND DISTANCE ESTABLISHED BY
DOUBLING DISTANCE PLAN - VIEW THROUGH THESE TWO CORNERS
(Show a minimum of three reference ties to durable physical objects, relevant monuments and physical conditions that will enable recovery of the corner.)

NO OTHER EVIDENCE COULD BE FOUND.

WOOD NAIL IN
POWER POLE

142.00'

SE CORNER OF
THE SW 1/4 OF THE
NE 1/4 OF SECTION
24, T87N, R3E
SET 5/8" X 36" IRON
ROD WITH ORANGE CAP NO
10134

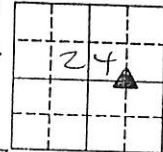

5/8" X 36"
IRON ROD
WITH ORANGE
CAP NO
10134

33.00'

36.13' FENCE

WOOD NAIL IN
WOOD FENCE POST

W
J
+
Y
J
W
S
N
A



I HEREBY CERTIFY THAT THIS LAND SURVEYING DOCUMENT WAS PREPARED AND THE RELATED SURVEY WORK WAS PERFORMED BY ME OR UNDER MY DIRECT PERSONAL SUPERVISION AND THAT I AM A DULY LICENSED LAND SURVEYOR UNDER THE LAWS OF THE STATE OF IOWA.

Paul C. Brashaw (DATE)

LICENSE NUMBER 10134

MY LICENSE RENEWAL DATE IS DECEMBER 31,

List Corners to be Indexed
Corners Section Top Range
SE corner 24 87N 3E
SW 1/4 NE 1/4

MONUMENT RECORD		
COUNTY: <u>JACKSON</u>		
TOWNSHIP: <u>PRAIRIE SPRINGS</u>		
DATE PLOTTED:	FIELD BOOK #	DRAWING
DATE REVISED:	PAGE #	#

FILE NO. 03-1929
BOOK 2 PAGE 67

03 APR -3 AM 7:30

PHYLLIS M. GERLACH
JACKSON COUNTY, IOWA
RECORDER

Fee 6.00

Preparer's Name: Paul C. Brashaw Address: 4413 West Stagecoach Trail Galena, Ill. Telephone: 777-1172

SLSI 9-94

UNITED STATES PUBLIC LAND SURVEY CORNER CERTIFICATE




OF

Land Survey Monuments situated in Section 24, Township 87 NORTH, Range 3 EAST, of the Fifth Principal Meridian, JACKSON County, Iowa.
Previously recorded in _____ in County Recorder's Office.
(book, page, document number, etc.)

(Show reason for preparing this certificate, the evidence and detailed procedures used in establishing the corner positions and monumentation found or placed.)

Monument Description and Remarks: CENTER OF SECTION 24, T87N, R3E
SET 5/8" X 36" IRON ROD WITH ORANGE CAP NO. 10134
ESTABLISHED BY EXTENSION OF LINE FROM JAMES L. EGGER
NO. 7983 FROM N 1/4 CORNER THROUGH 1/4 CORNER ROD
AND DISTANCE ESTABLISHED BY DOUBLING DISTANCE THROUGH
SAME TWO CORNERS PLAN - VIEW NO OTHER EVIDENCE COULD
(Show a minimum of three reference ties to durable physical objects, relevant monuments and physical conditions that will enable recovery of the corner.)
BE FOUND.

CENTER OF SECTION 24 T87N, R3E
SET 5/8" X 36" IRON ROD WITH
ORANGE CAP NO 10134.

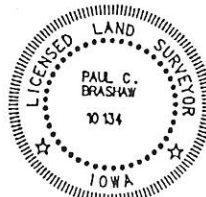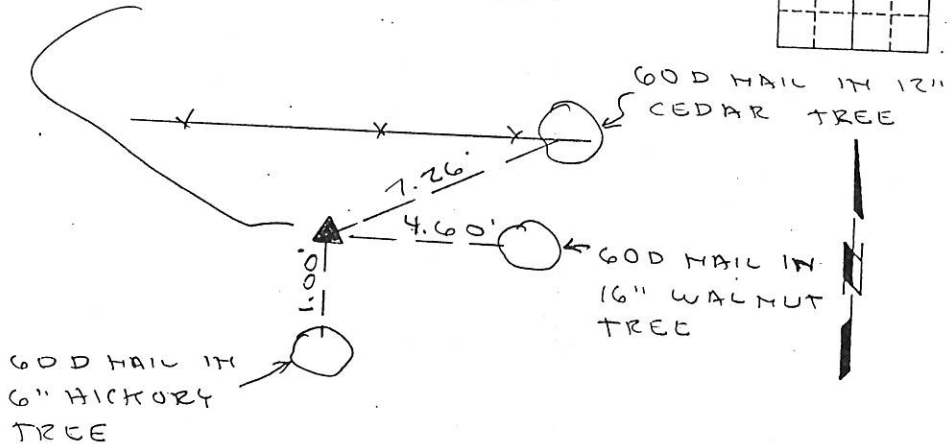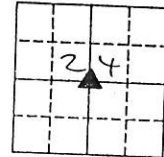

I HEREBY CERTIFY THAT THIS LAND SURVEYING DOCUMENT WAS PREPARED AND THE RELATED SURVEY WORK WAS PERFORMED BY ME OR UNDER MY DIRECT PERSONAL SUPERVISION AND THAT I AM A DULY LICENSED LAND SURVEYOR UNDER THE LAWS OF THE STATE OF IOWA.

Paul C. Brashaw 3/31/2003
PAUL C. BRASHAW (DATE)

LICENSE NUMBER 10134

MY LICENSE RENEWAL DATE IS DECEMBER 31, 2004

List Corners to be Indexed
Corners Section Top Range
CENTER 24 87N R3E

MONUMENT RECORD		
COUNTY: <u>JACKSON</u>		
TOWNSHIP: <u>PRAIRIE SPRINGS</u>		
DATE PLOTTED:	FIELD BOOK #	DRAWING
DATE REVISED:	PAGE #	#